



560 5th St. NW // Suite 305 // Grand Rapids, MI 49504 616.827.4270

www.bergmannpc.com



# ORCHARD VIEW SCHOOL DISTRICT

## COMMUNITY EDUCATION CENTER

RENOVATIONS - BID PACKAGE NO. 1 1765 ADA AVENUE MUSKEGON, MI 49442

2/17/2023

### PROJECT CONTACT LIST

- OWNER:
   ORCHARD VIEW SCHOOLS
   35 S SHERIDAN DR MUSKEGON, MI
- CONTACT:
- BRANDY CAREY JACK TIMMER

### <u>ELECTRICAL ENGINEER:</u> - BERGMANN

- 7050 W SAGINAW HWY, SUITE 200
- LANSING, MI - CONTACT: ANGELA ROBINSON
- PHONE: 517.827.8726

### STRUCTURAL ENGINEER: - BERGMANN

- 7050 W SAGINAW HWY, SUITE 200 LANSING, MI
- CONTACT: KIRA TENNES - PHONE: 517.272.9835

- CONTACT: BUDDY HUYLER - PHONE: 616.848.6969

- MECHANICAL ENGINEER:
   ABILITY ENGINEERING
   5210 WEST RIVER DR NE, SUITE C
- COMSTOCK PARK, MI
   CONTACT: CHRIS NOLAN

### - PHONE: 616.232.5817

### PROJECT LOCATION MAP



A002	GENERAL REQUIREMENTS
A003	SPECIFICATIONS
AD101	FIRST FLOOR DEMOLITION PLAN
AD121	FIRST FLOOR DEMOLITION CEILING PLAN AND EXTERIOR ELEVATION
A101	FIRST FLOOR PLAN
A103	ROOF PLAN
A121	FIRST FLOOR CEILING PLAN
A141	FIRST FLOOR FINISH PLAN
A201	EXTERIOR ELEVATIONS
A301	WALL SECTIONS
A302	WALL SECTIONS
A303	WALL SECTIONS
A601	SCHEDULES, DOOR AND WINDOW DETAILS
05 - MECHANICAL	
MD01	FIRST FLOOR MECHANICAL AND PLUMBING DEMOLITION PLAN
M001	GENERAL MECHANICAL INFORMATION
M101	FIRST FLOOR MECHANICAL PLANS
08 - ELECTRICAL	
E001	LECEND

**DRAWING INDEX** 

G001 CODE COMPLIANCE & LIFE SAFETY PLANS

G000 COVER SHEET

04 - ARCHITECTURAL


S101 STRUCTURAL DETAILS

A001 GENERAL NOTES AND LEGENDS

08 - ELECTRICAL	
E001	LEGEND
E002	SPECIFICATIONS
ED101	ELECTRICAL DEMOLITION PLAN
E101	POWER PLAN
E201	LIGHTING PLAN
E601	ONE-LINE DIAGRAM
E701	DETAILS
E801	SCHEDULES
E802	SCHEDULES

DATE	DESCRIPTION
12/14/2022	BID PACKAGE - WINDOWS
1/24/2023	BID PACKAGE #1 - OWNER REVIEW
1/31/2023	BID PACKAGE #1 - BIDS
2/7/2023	BID PACKAGE #1 - PERMITS
2/15/2023	BID PACKAGE #1 - ADDENDUM #1
2/17/2023	BID PACKAGE #1 - ADDENDUM #2

**G000** 

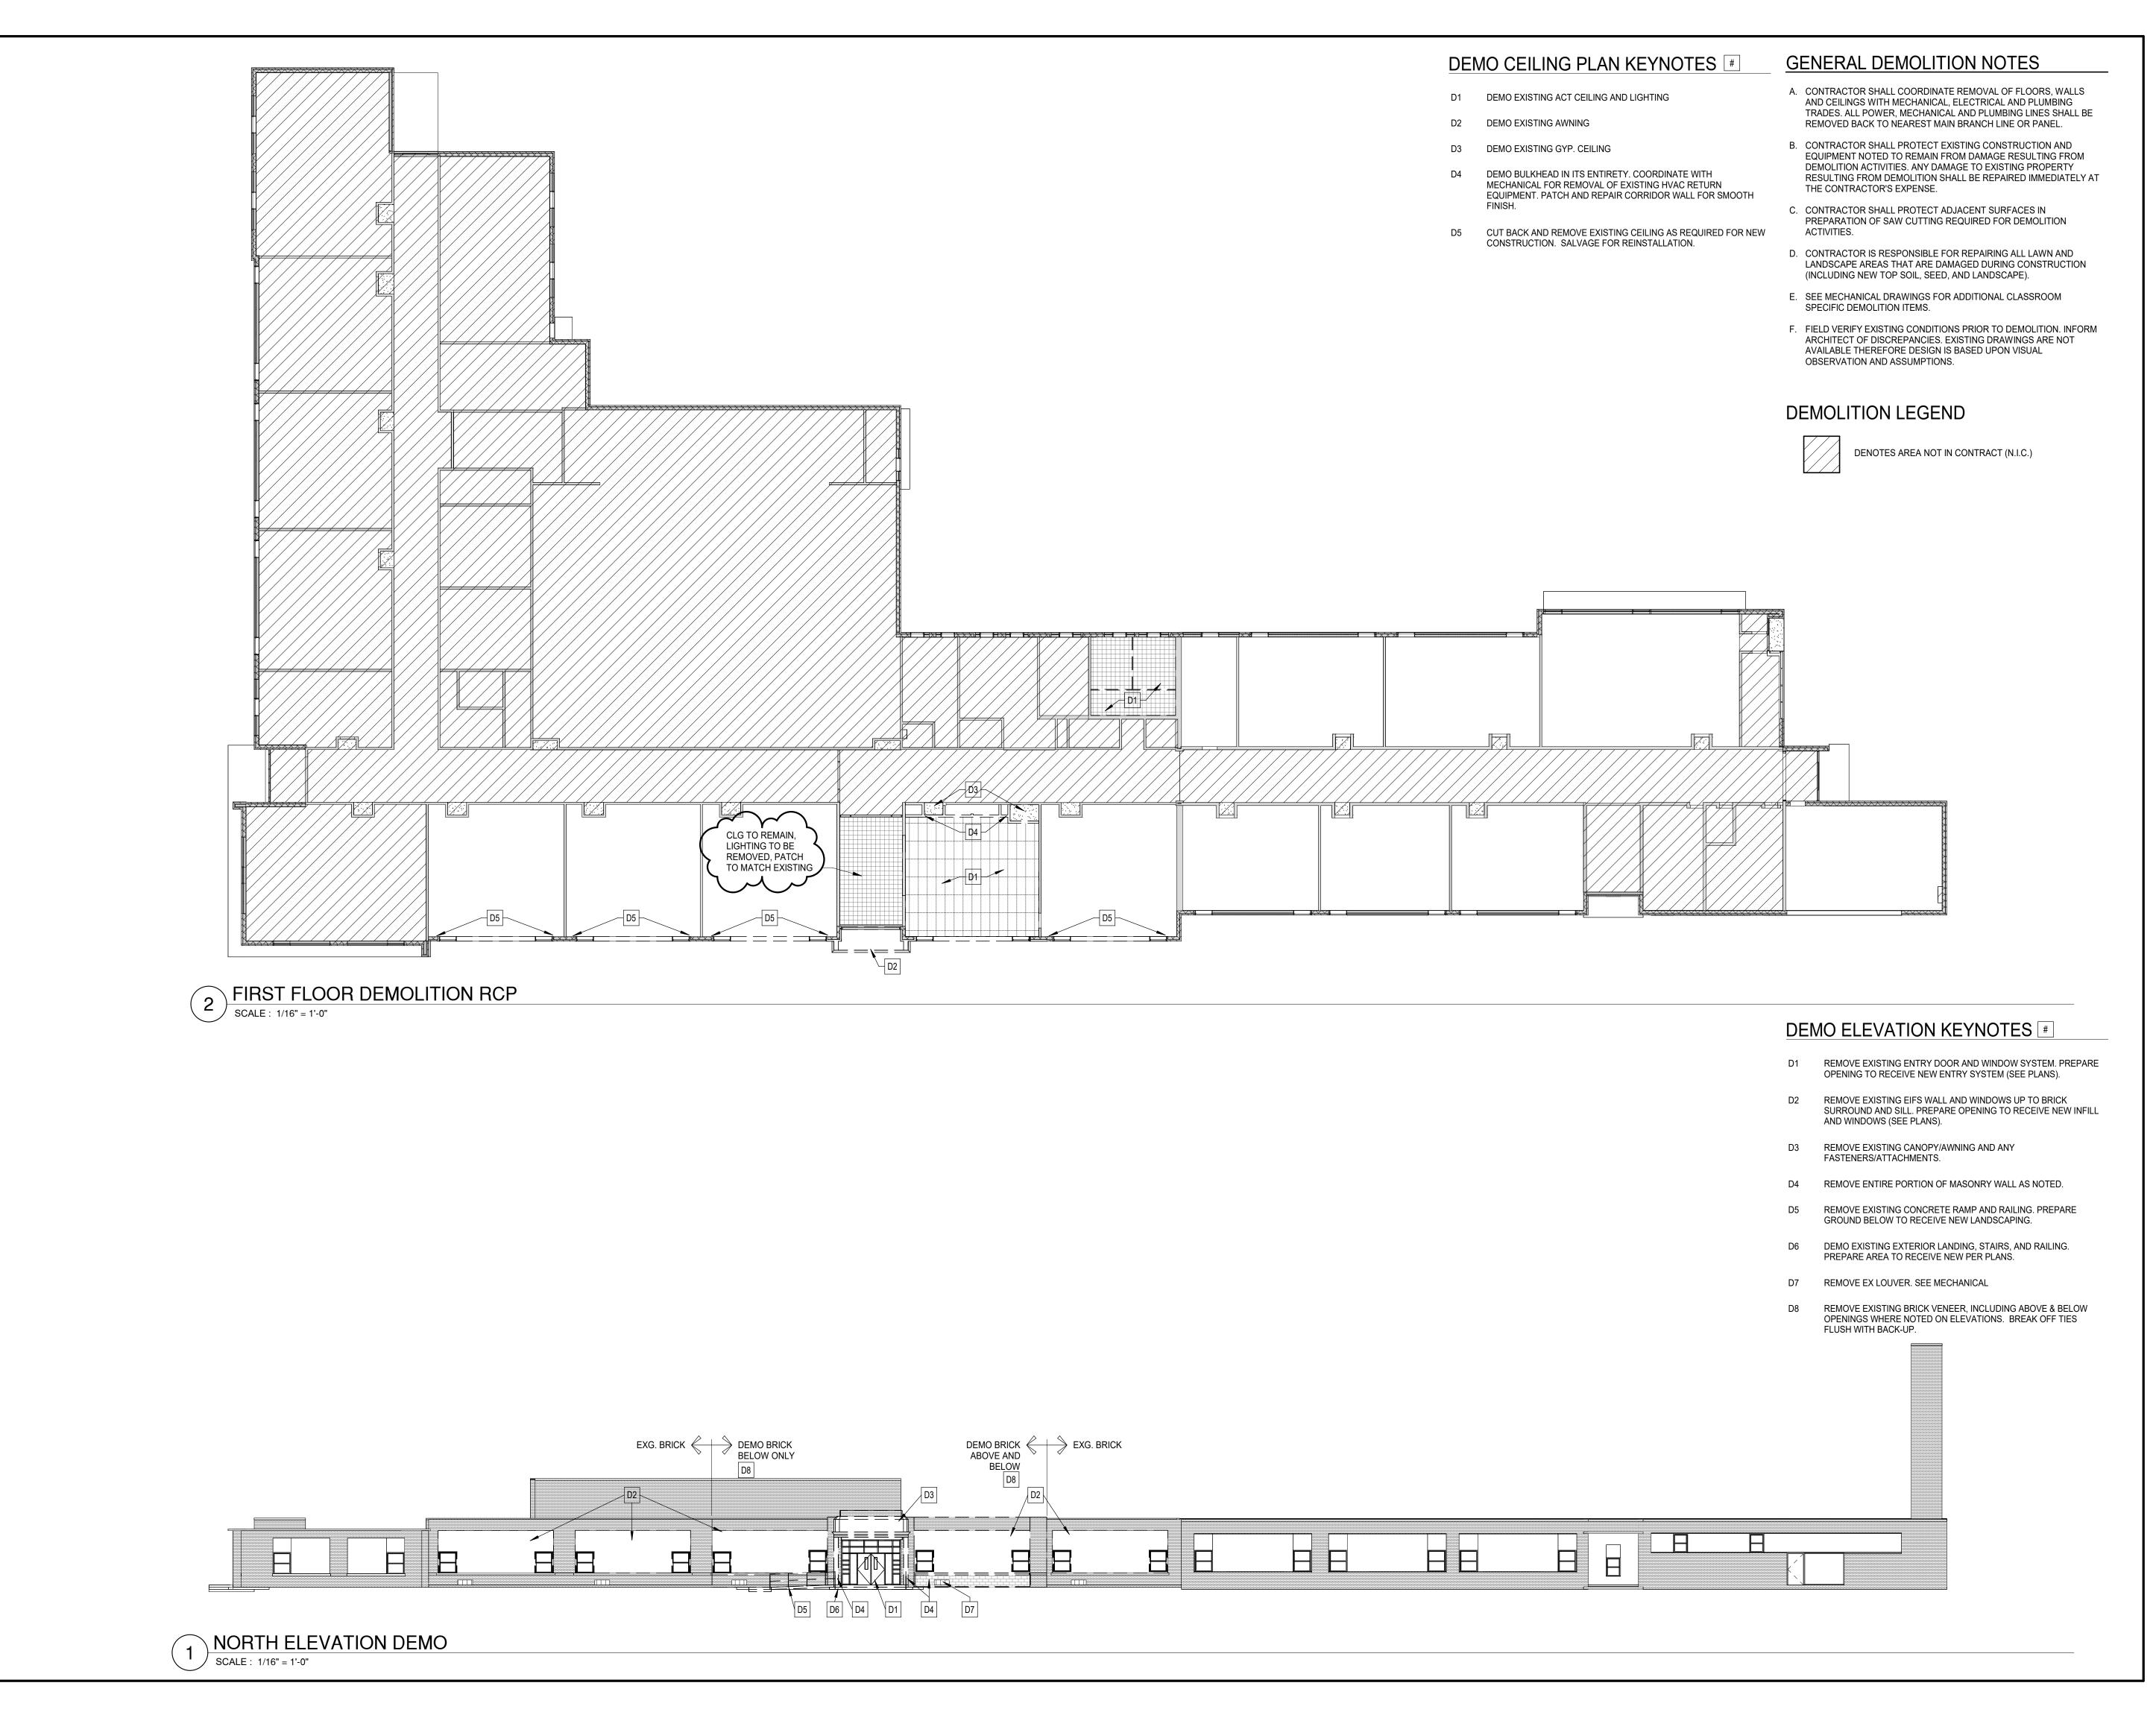



560 5th St. NW Suite 305 Grand Rapids, MI 49504


www.bergmannpc.com

# ORCHARD VIEW SCHOOL DISTRICT

### COMMUNITY EDUCATION CENTER

1765 ADA AVENUE MUSKEGON, MI 49442

Date Revised	Description	
1/24/2023	BID PACKAGE #1 - OWNER REVIEW	
1/31/2023	BID PACKAGE #1 - BIDS	
2/7/2023	BID PACKAGE #1 - PERMITS	
2/15/2023	BID PACKAGE #1 - ADDENDUM #1	
2/17/2023	BID PACKAGE #1 - ADDENDUM #2	

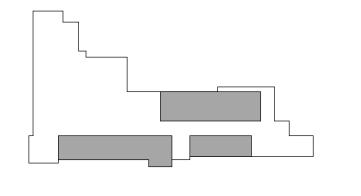

Key Plan

Copyright © Bergmann Associates, Architects, Engineers, Landscape Architects & Surveyors, D.P.C.


Project Manager	Discipline Lead
D HOLTROP	B HUYLER
Designer	Reviewer
E POST	R KEUNEKE
Date Issued	Project Number
2/17/2023	16600.00


Sheet Name

FIRST FLOOR DEMOLITION
CEILING PLAN AND
EXTERIOR ELEVATION

Drawing Number

**AD121** 

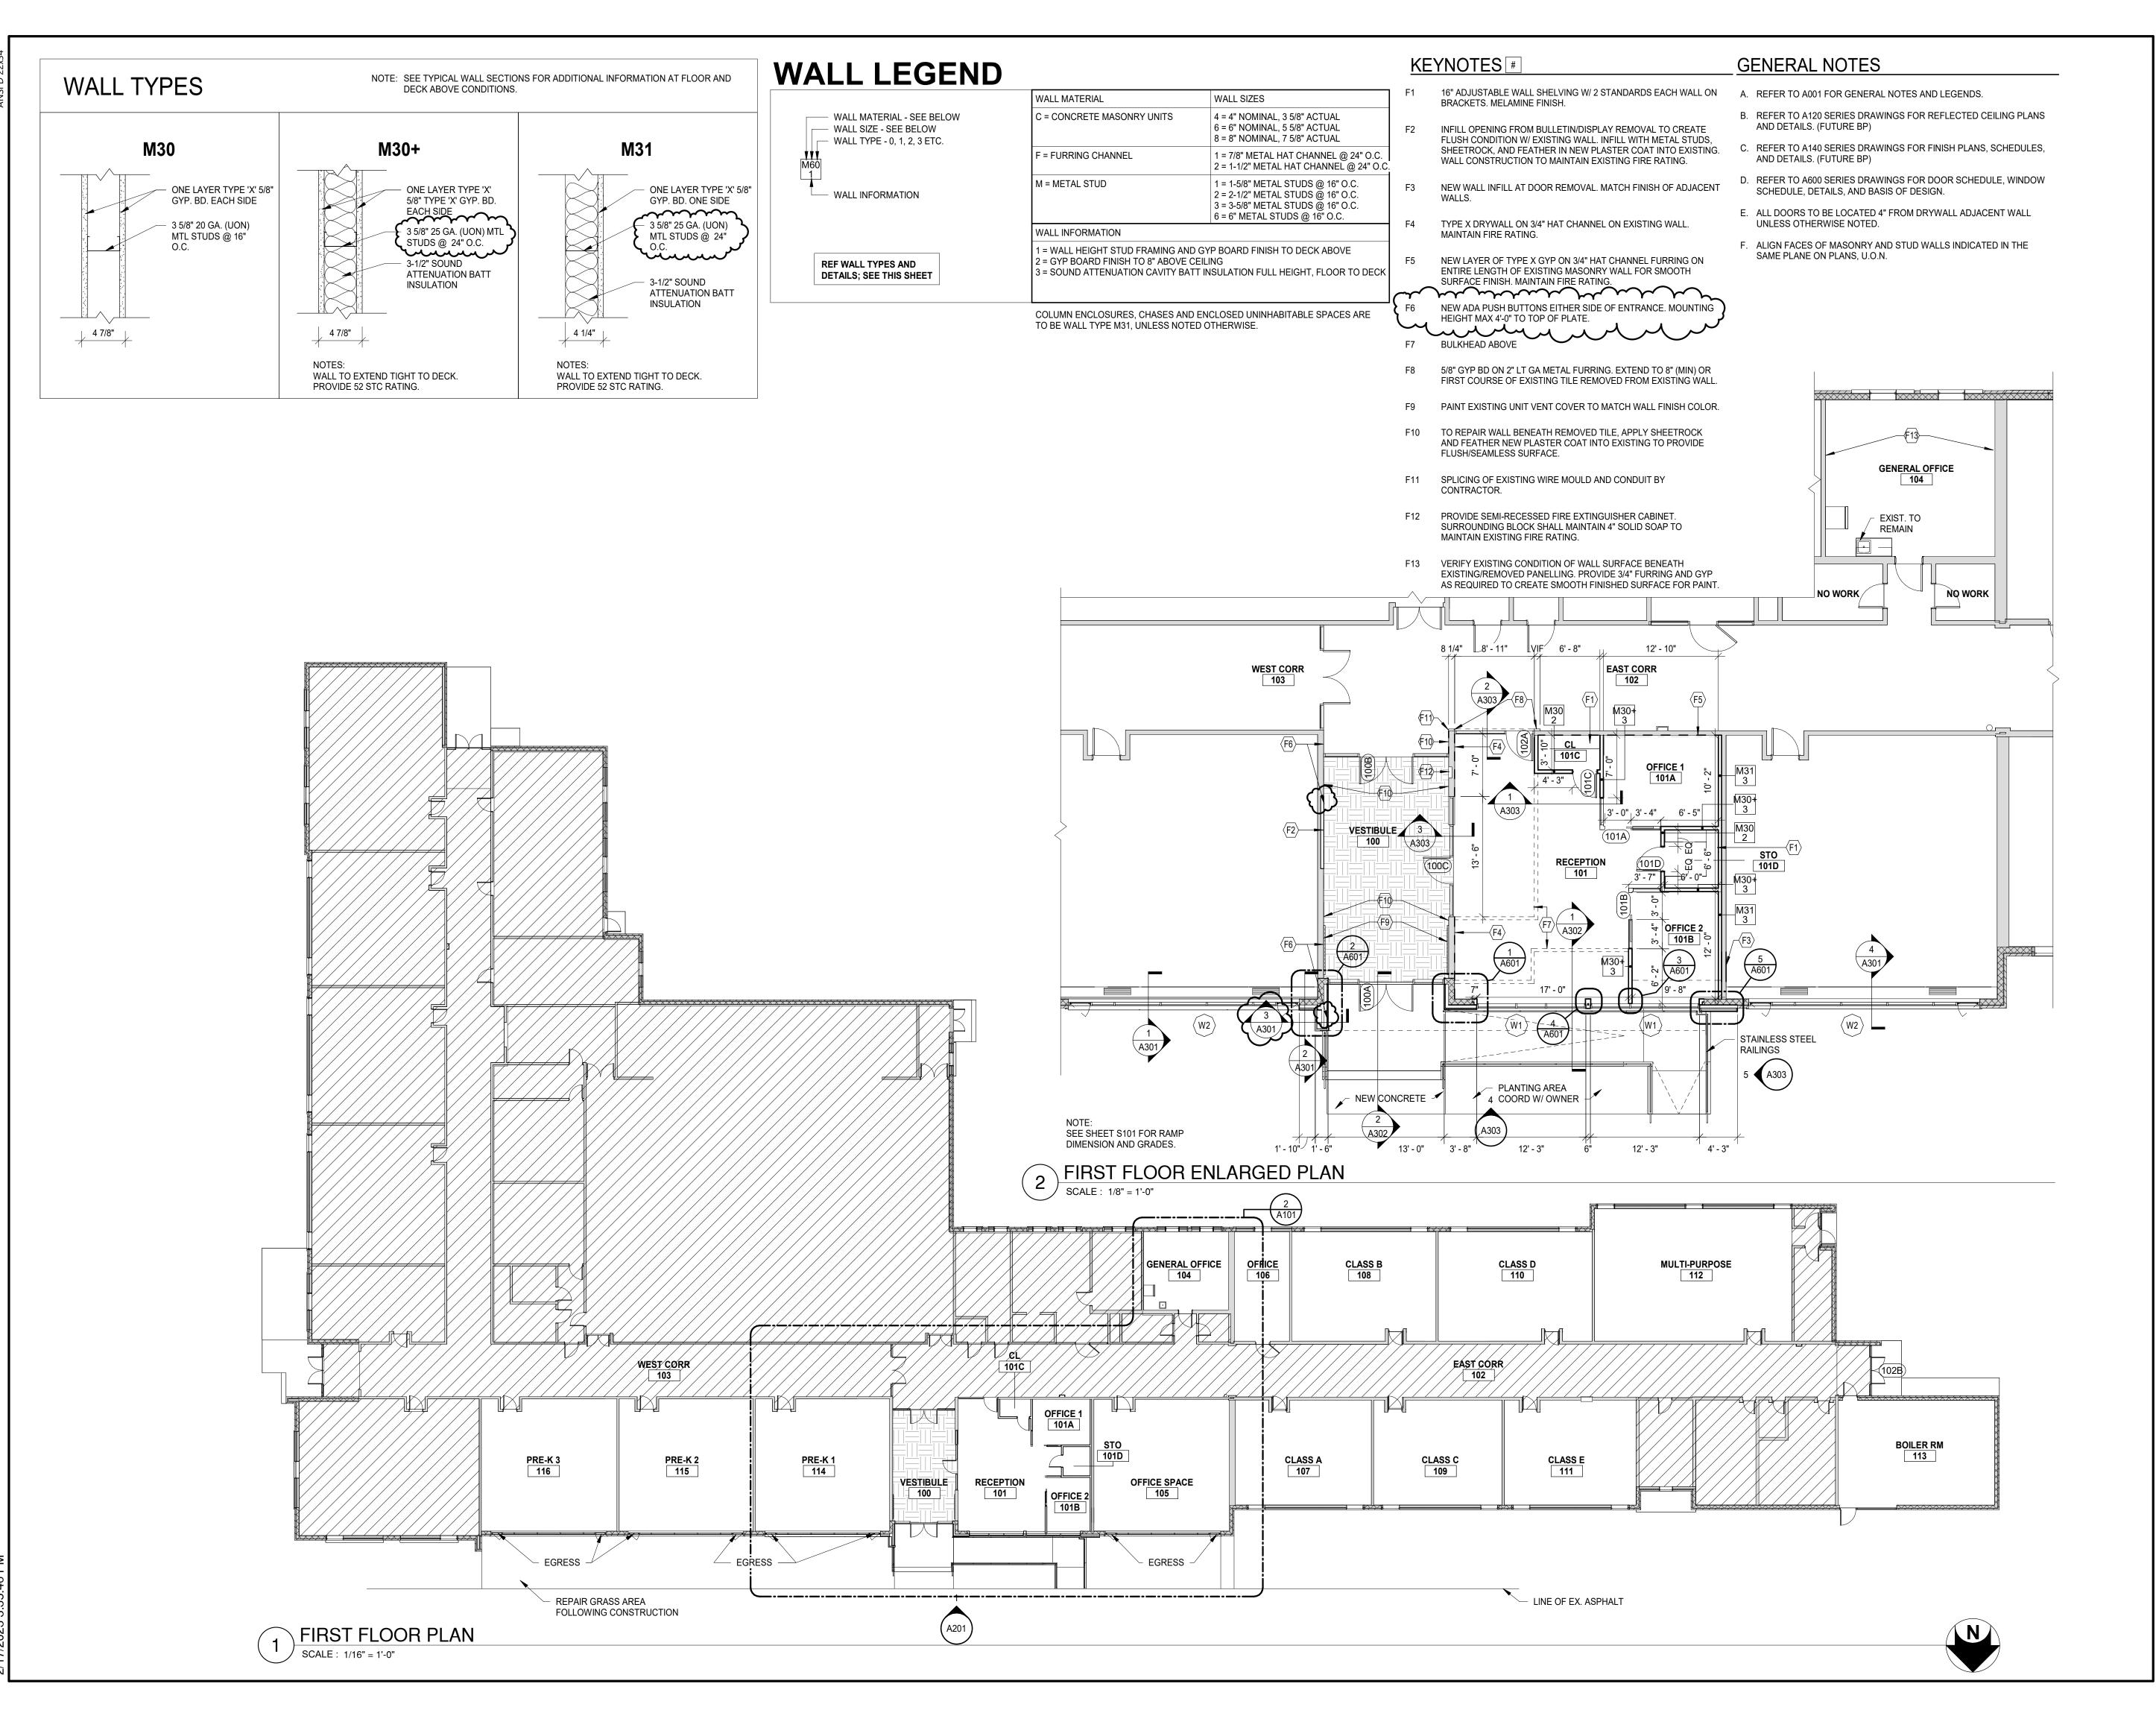

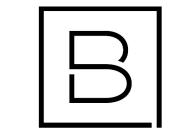

## BERGMANN

ARCHITECTS ENGINEERS PLANNERS

560 5th St. NW Suite 305 Grand Rapids, MI 49504


www.bergmannpc.com

# ORCHARD VIEW SCHOOL DISTRICT

## COMMUNITY EDUCATION CENTER

1765 ADA AVENUE MUSKEGON, MI 49442

Date Revised	Description
1/24/2023	BID PACKAGE #1 - OWNER REVIEW
1/31/2023	BID PACKAGE #1 - BIDS
2/7/2023	BID PACKAGE #1 - PERMITS
2/15/2023	BID PACKAGE #1 - ADDENDUM #1
2/17/2023	BID PACKAGE #1 - ADDENDUM #2

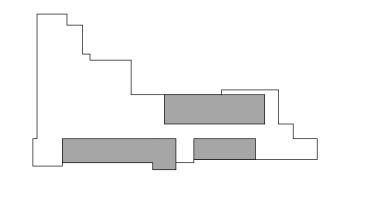

Key Plan


Copyright © Bergmann Associates, Architects, Engineers, Landscape Architects & Surveyors, D.P.C.

Project Manager	Discipline Lead
D HOLTROP	B HUYLER
Designer	Reviewer
E POST	R KEUNEKE
Date Issued	Project Number
2/17/2023	16600.00

Sheet Name

FIRST FLOOR PLAN

Drawing Number

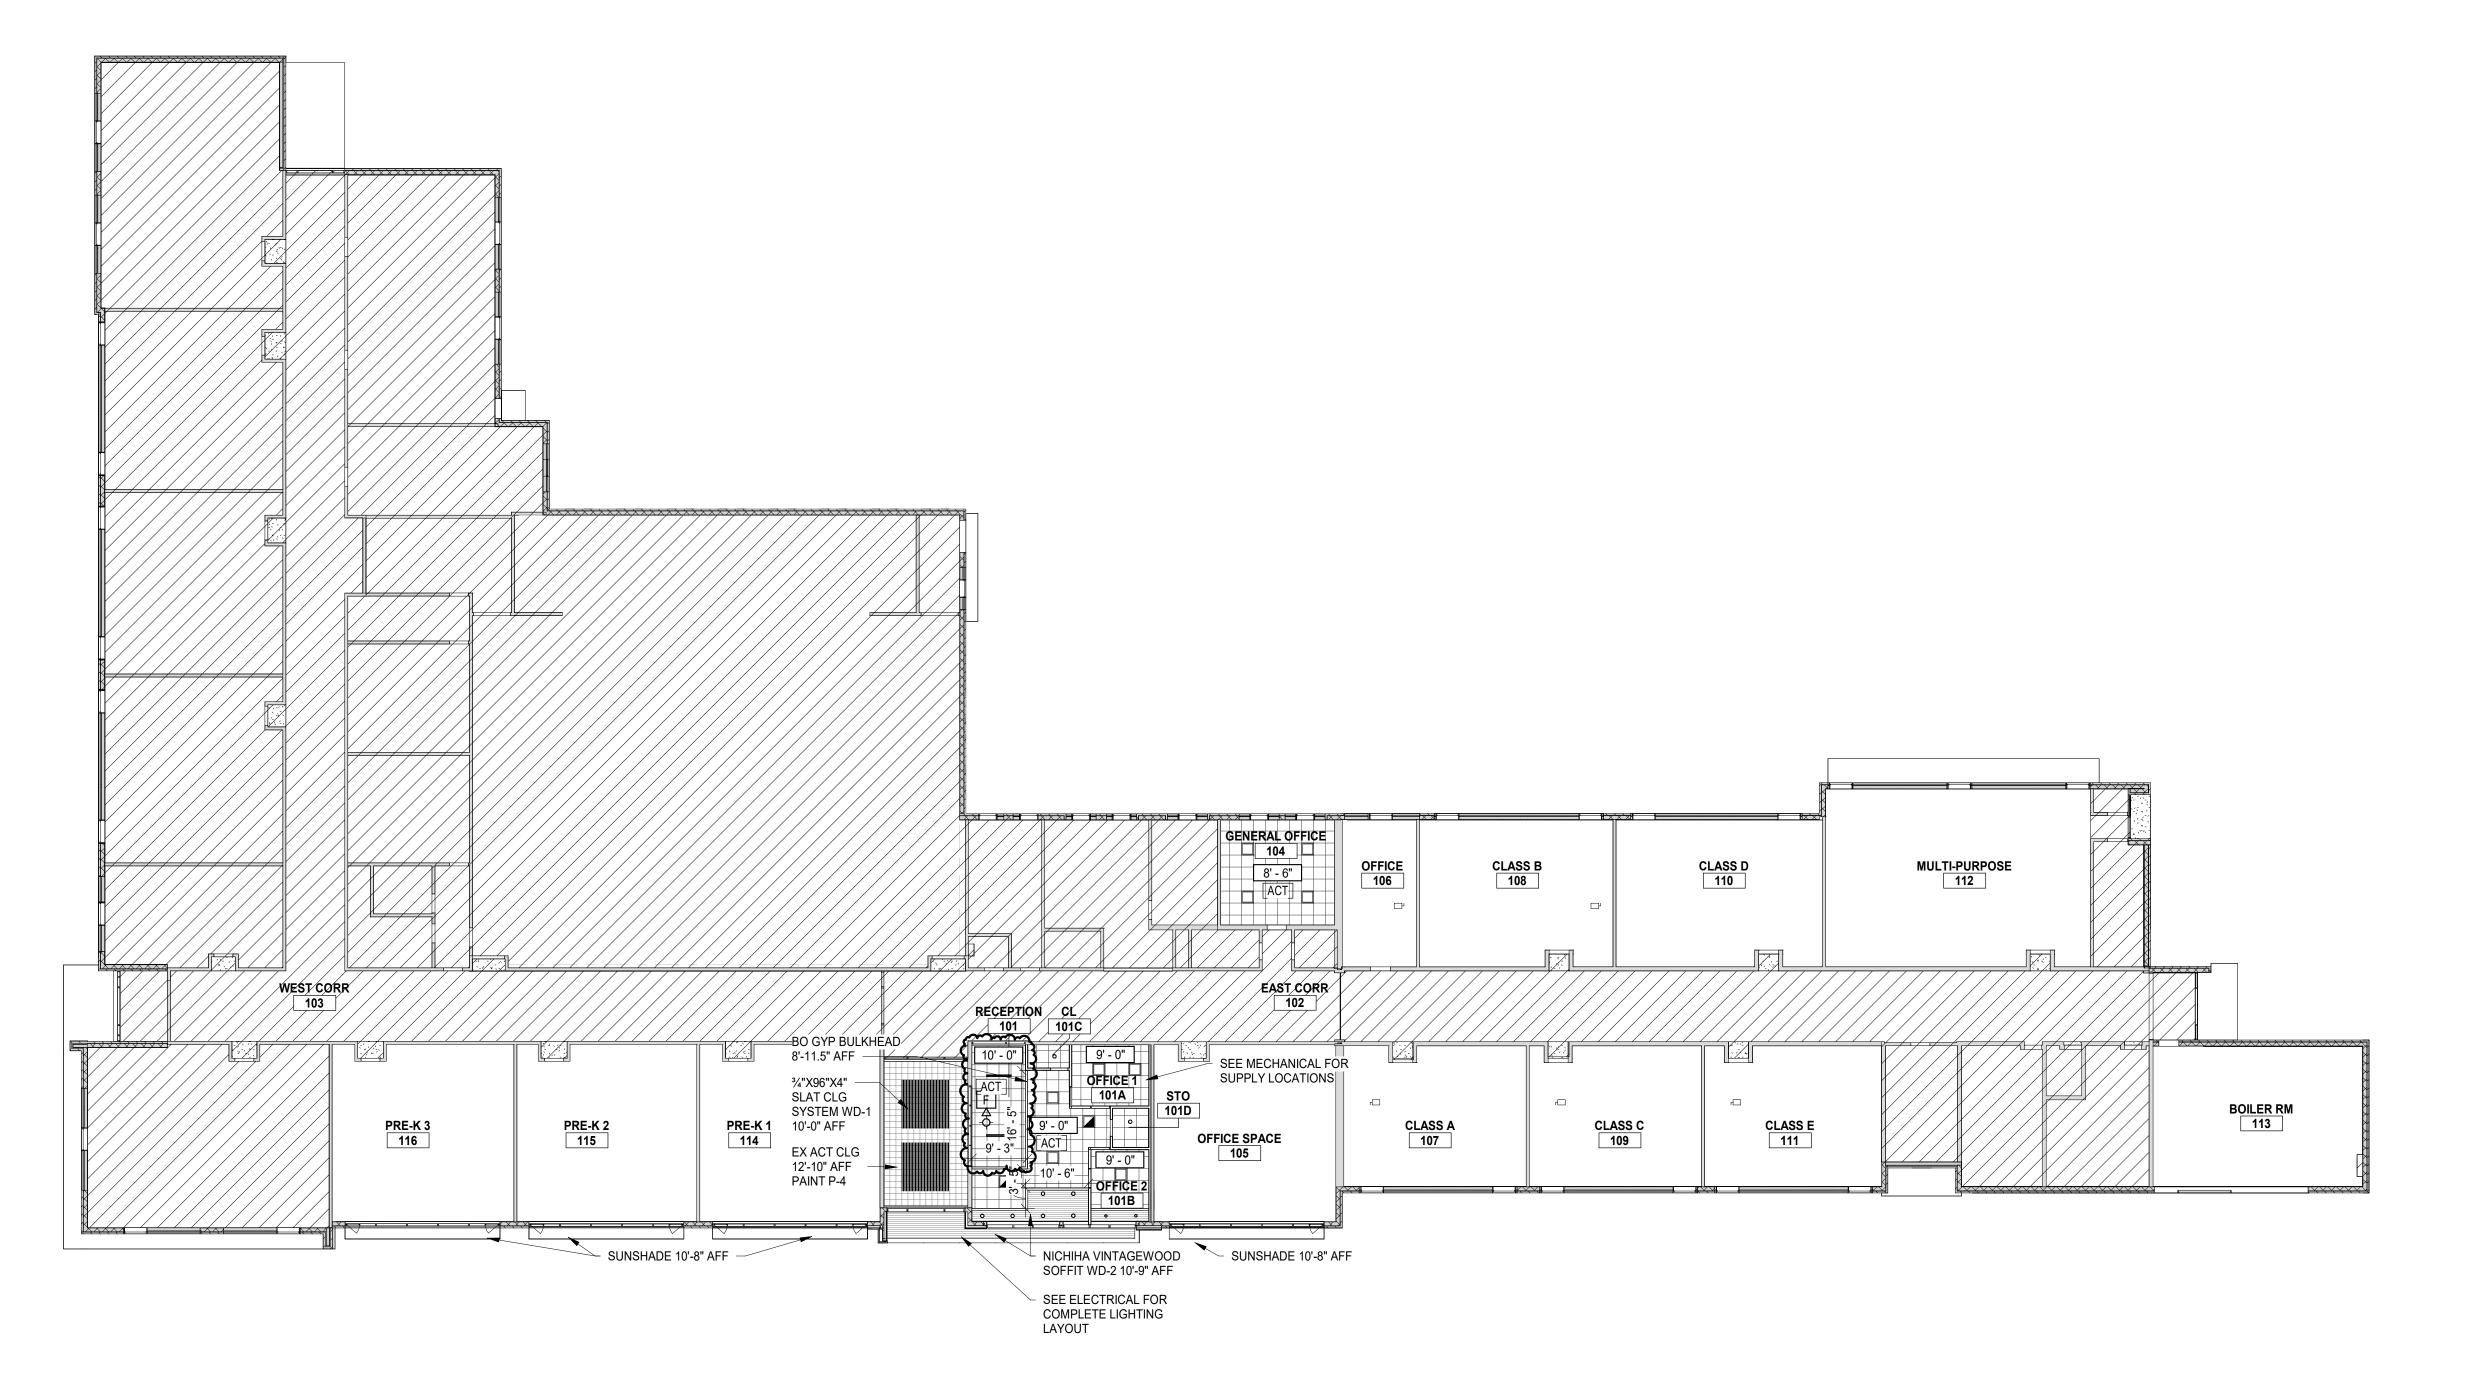

BERGMANN
ARCHITECTS ENGINEERS PLANNERS

560 5th St. NW Suite 305 Grand Rapids, MI 49504

www.bergmannpc.com


OPEN TO DECK

# ORCHARD VIEW SCHOOL DISTRICT

### COMMUNITY EDUCATION CENTER

1765 ADA AVENUE MUSKEGON, MI 49442

Date Revised	Description
1/24/2023	BID PACKAGE #1 - OWNER REVIEW
1/31/2023	BID PACKAGE #1 - BIDS
2/7/2023	BID PACKAGE #1 - PERMITS
2/15/2023	BID PACKAGE #1 - ADDENDUM #1
2/17/2023	BID PACKAGE #1 - ADDENDUM #2

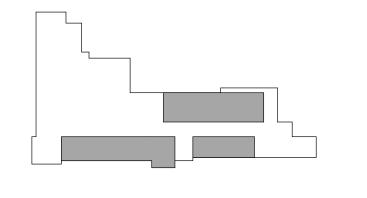

Key Plan


Copyright © Bergmann Associates, Architects, Engineers, Landscape Architects & Surveyors, D.P.C.

Project Manager	Discipline Lead
D HOLTROP	B HUYLER
Designer	Reviewer
E POST	R KEUNEKE
Date Issued	Project Number
2/17/2023	16600.00

Sheet Name

FIRST FLOOR CEILING PLAN

Drawing Numb

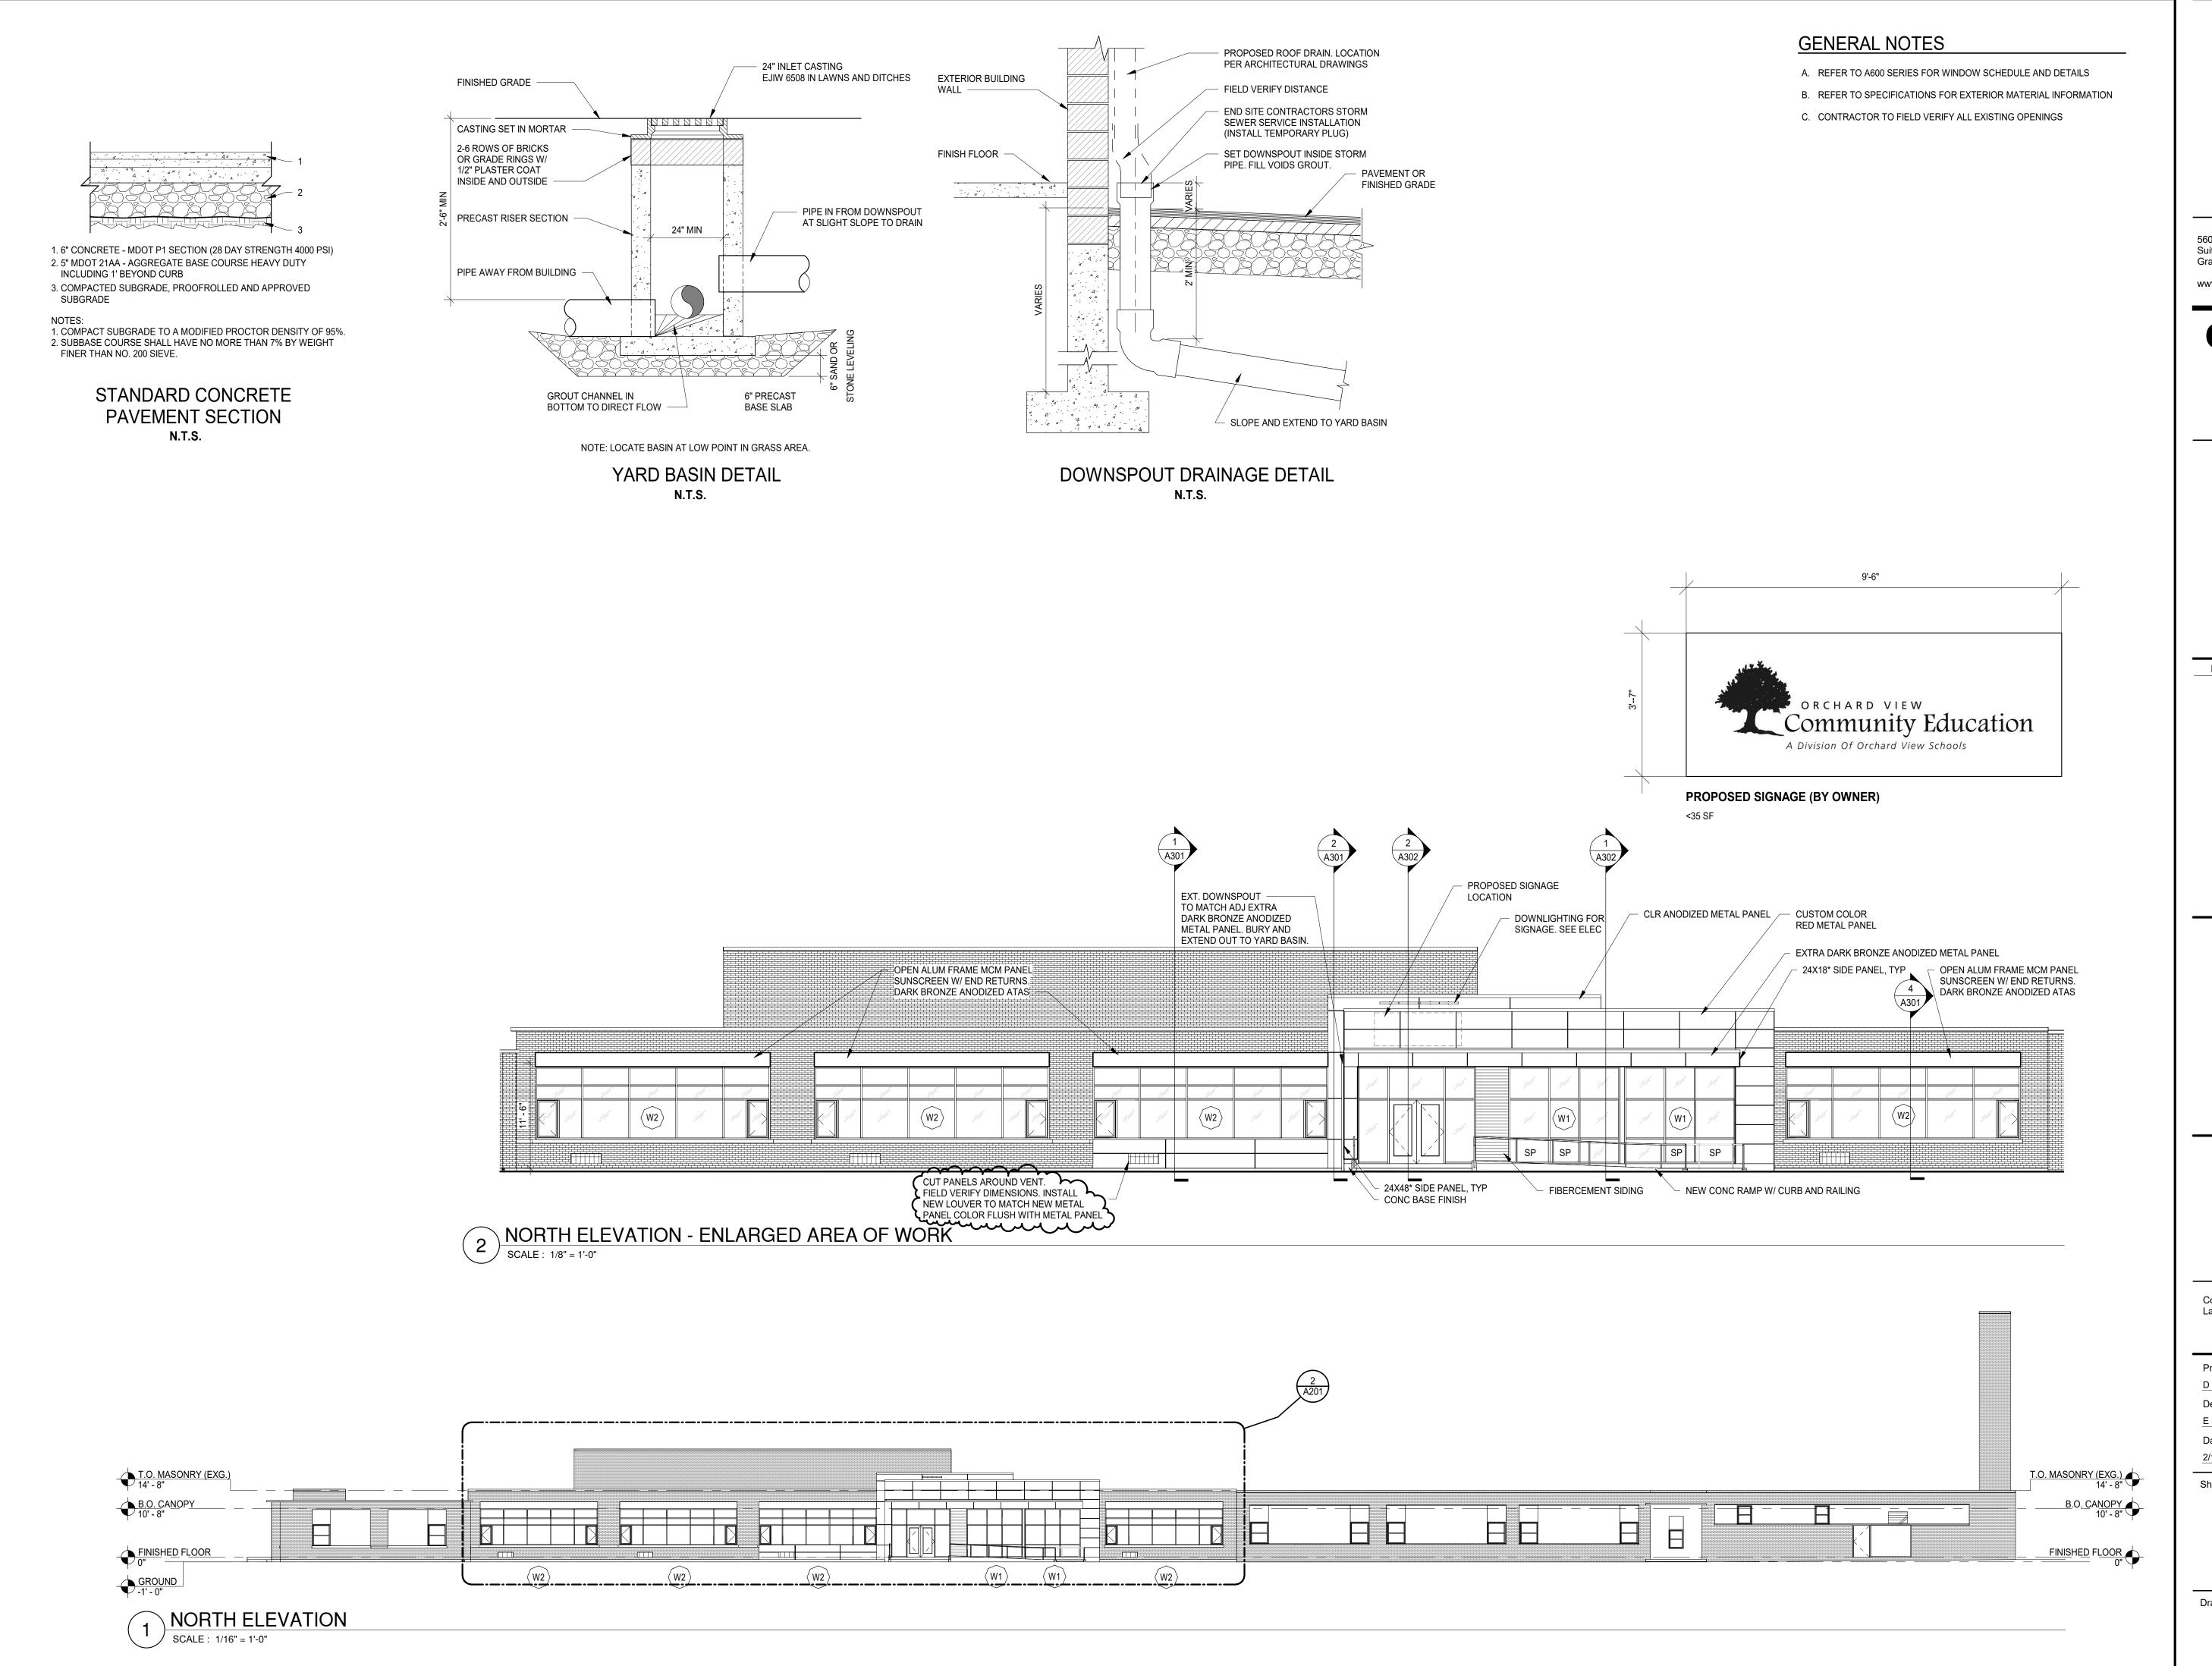

BERGMANN

ARCHITECTS ENGINEERS PLANNERS

560 5th St. NW Suite 305 Grand Rapids, MI 49504

www.bergmannpc.com

# ORCHARD VIEW SCHOOL DISTRICT

### COMMUNITY EDUCATION CENTER

1765 ADA AVENUE MUSKEGON, MI 49442

Description
DID DACKACE #4 OWNED DEVIEW
BID PACKAGE #1 - OWNER REVIEW BID PACKAGE #1 - BIDS
BID PACKAGE #1 - PERMITS
BID PACKAGE #1 - ADDENDUM #1
BID PACKAGE #1 - ADDENDUM #2


Copyright © Bergmann Associates, Architects, Engineers, Landscape Architects & Surveyors, D.P.C.

Project Manager	Discipline Lead
D HOLTROP	B HUYLER
Designer	Reviewer
E POST	R KEUNEKE
Date Issued 2/17/2023	Project Number
2/11/2023	10000.00

Sheet Name

**EXTERIOR ELEVATIONS** 

Drawing Number

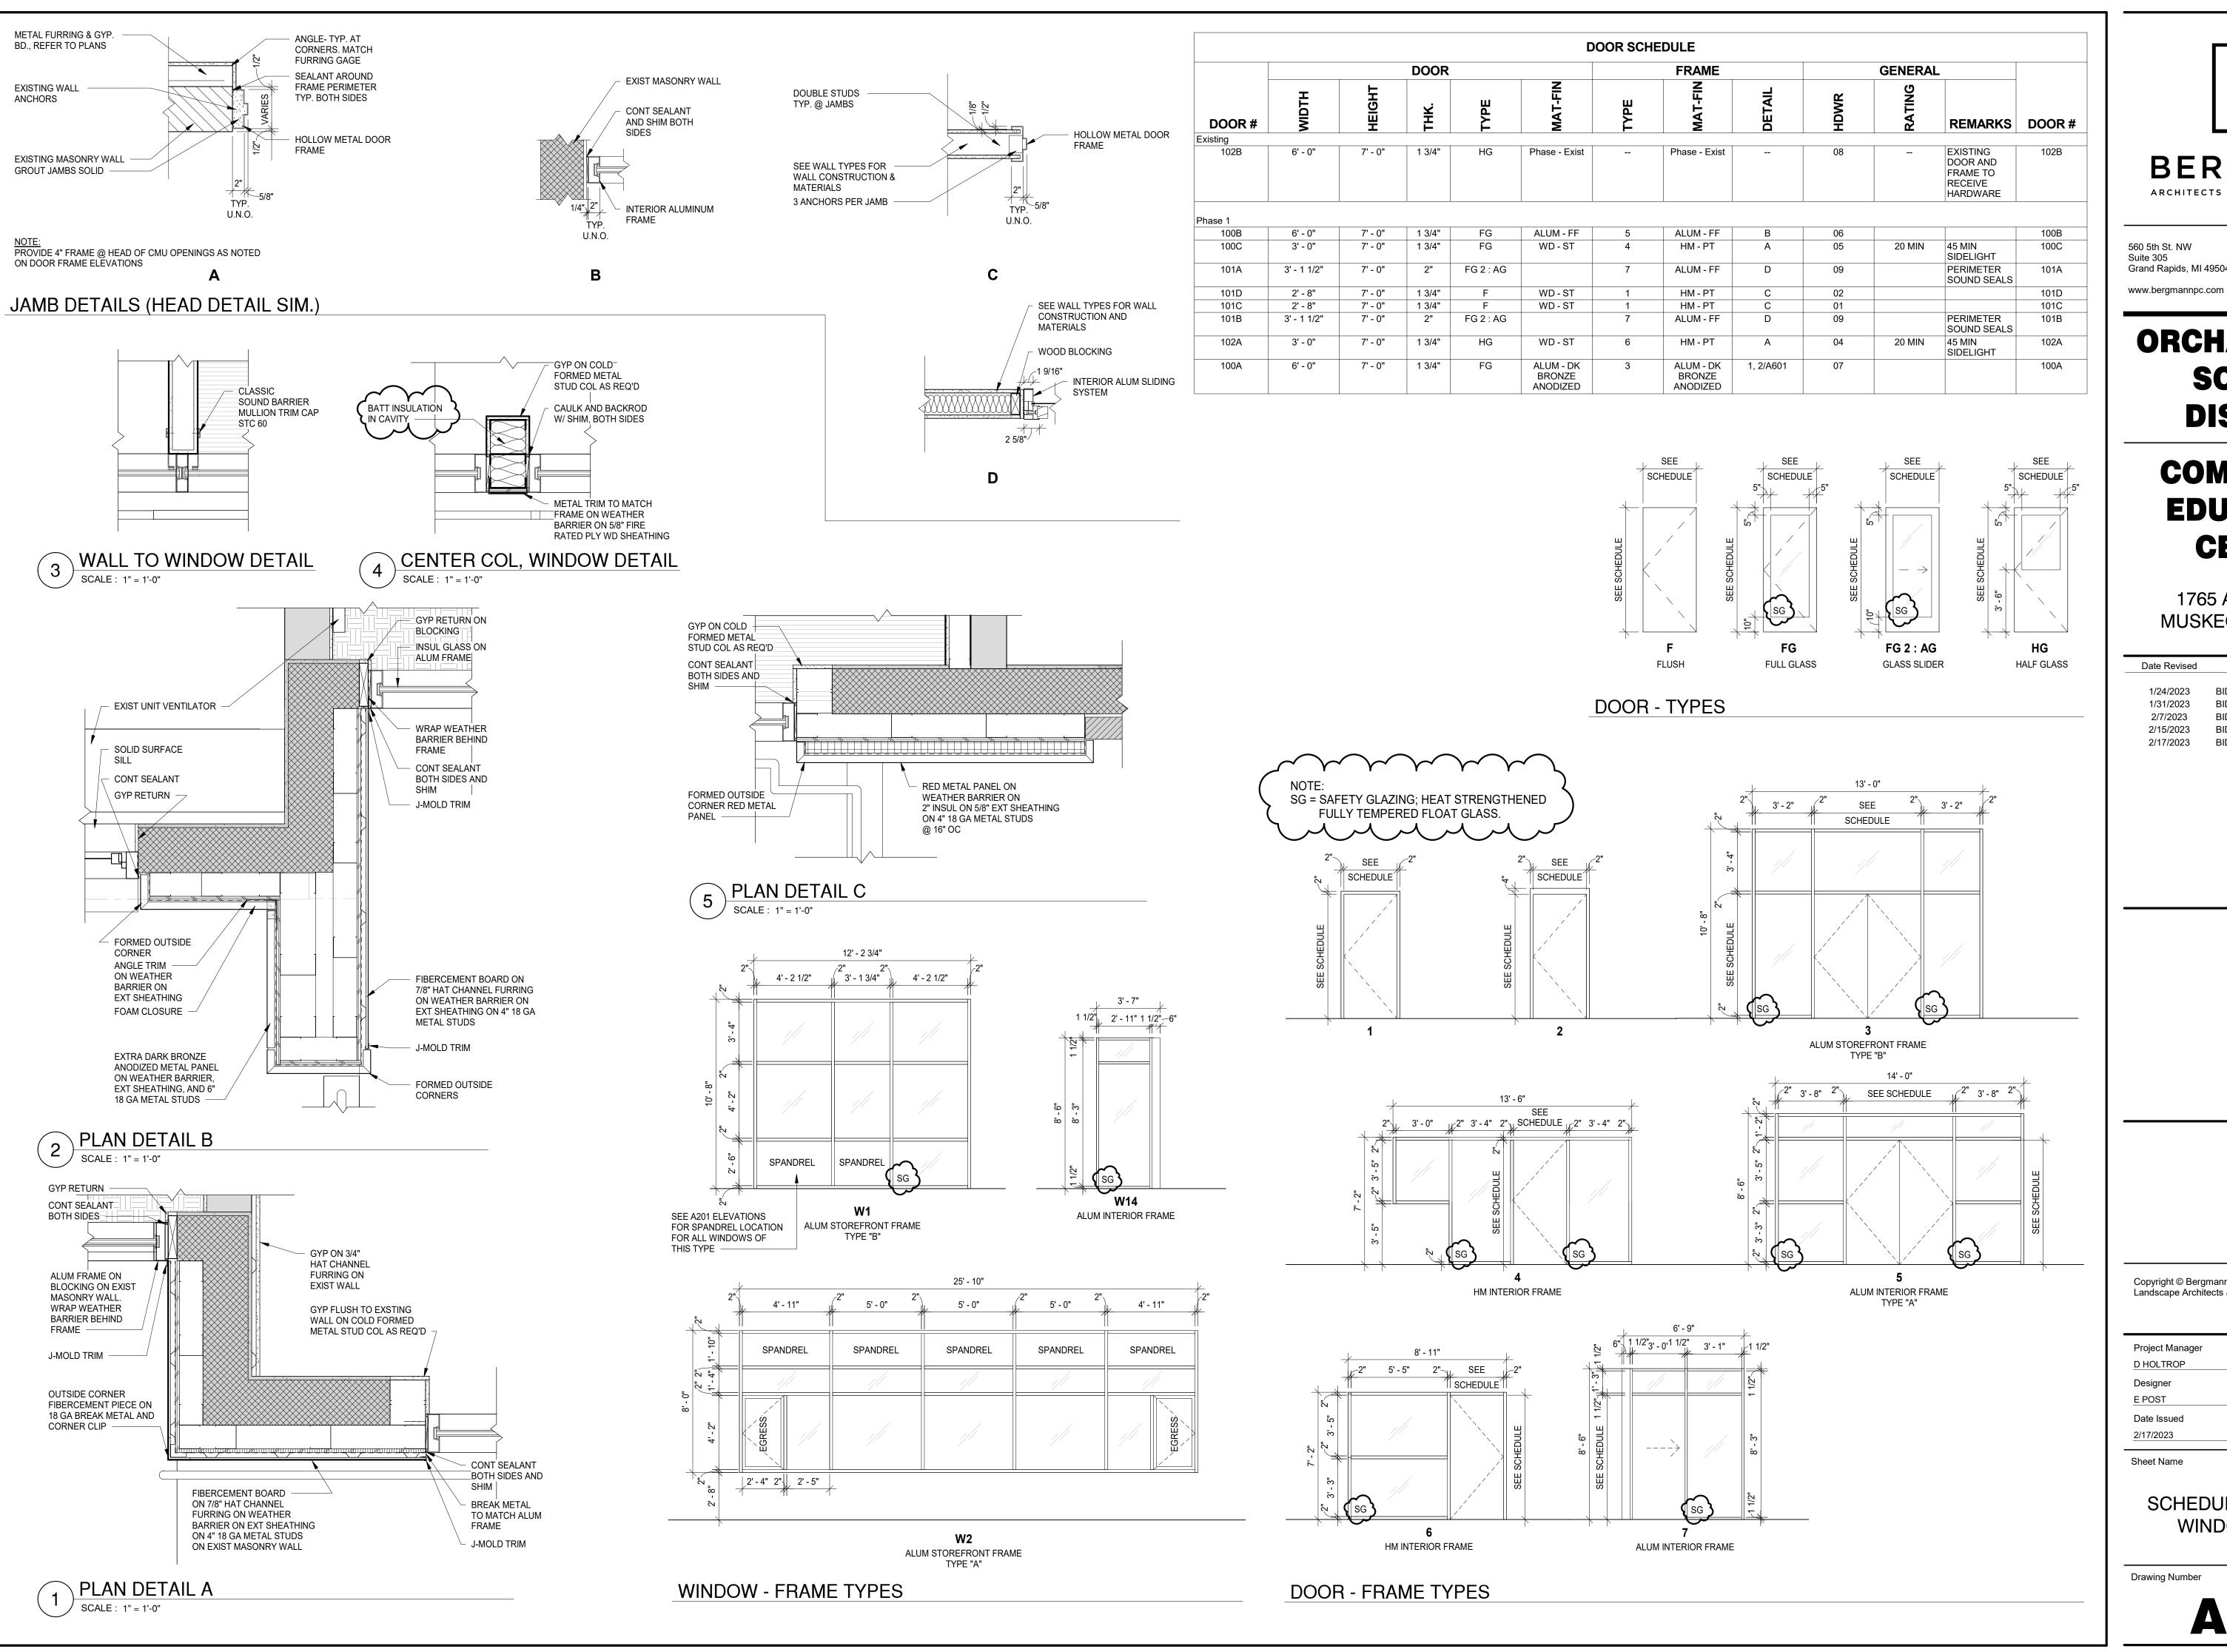

### BERGMANN ARCHITECTS ENGINEERS PLANNERS

560 5th St. NW Grand Rapids, MI 49504

**ORCHARD VIEW** 

# **SCHOOL DISTRICT**

### COMMUNITY **EDUCATION CENTER**

1765 ADA AVENUE MUSKEGON, MI 49442

Date Revised		Description
	1/24/2023	BID PACKAGE #1 - OWNER REVIEW
	1/31/2023	BID PACKAGE #1 - BIDS
	2/7/2023	BID PACKAGE #1 - PERMITS
	2/15/2023	BID PACKAGE #1 - ADDENDUM #1
	2/17/2023	BID PACKAGE #1 - ADDENDUM #2


Copyright © Bergmann Associates, Architects, Engineers, Landscape Architects & Surveyors, D.P.C.

Project Manager	Discipline Lead
D HOLTROP	B HUYLER
Designer	Reviewer
E POST	R KEUNEKE
Date Issued	Project Number
2/17/2023	16600.00

Sheet Name

SCHEDULES, DOOR AND WINDOW DETAILS

**Drawing Number** 

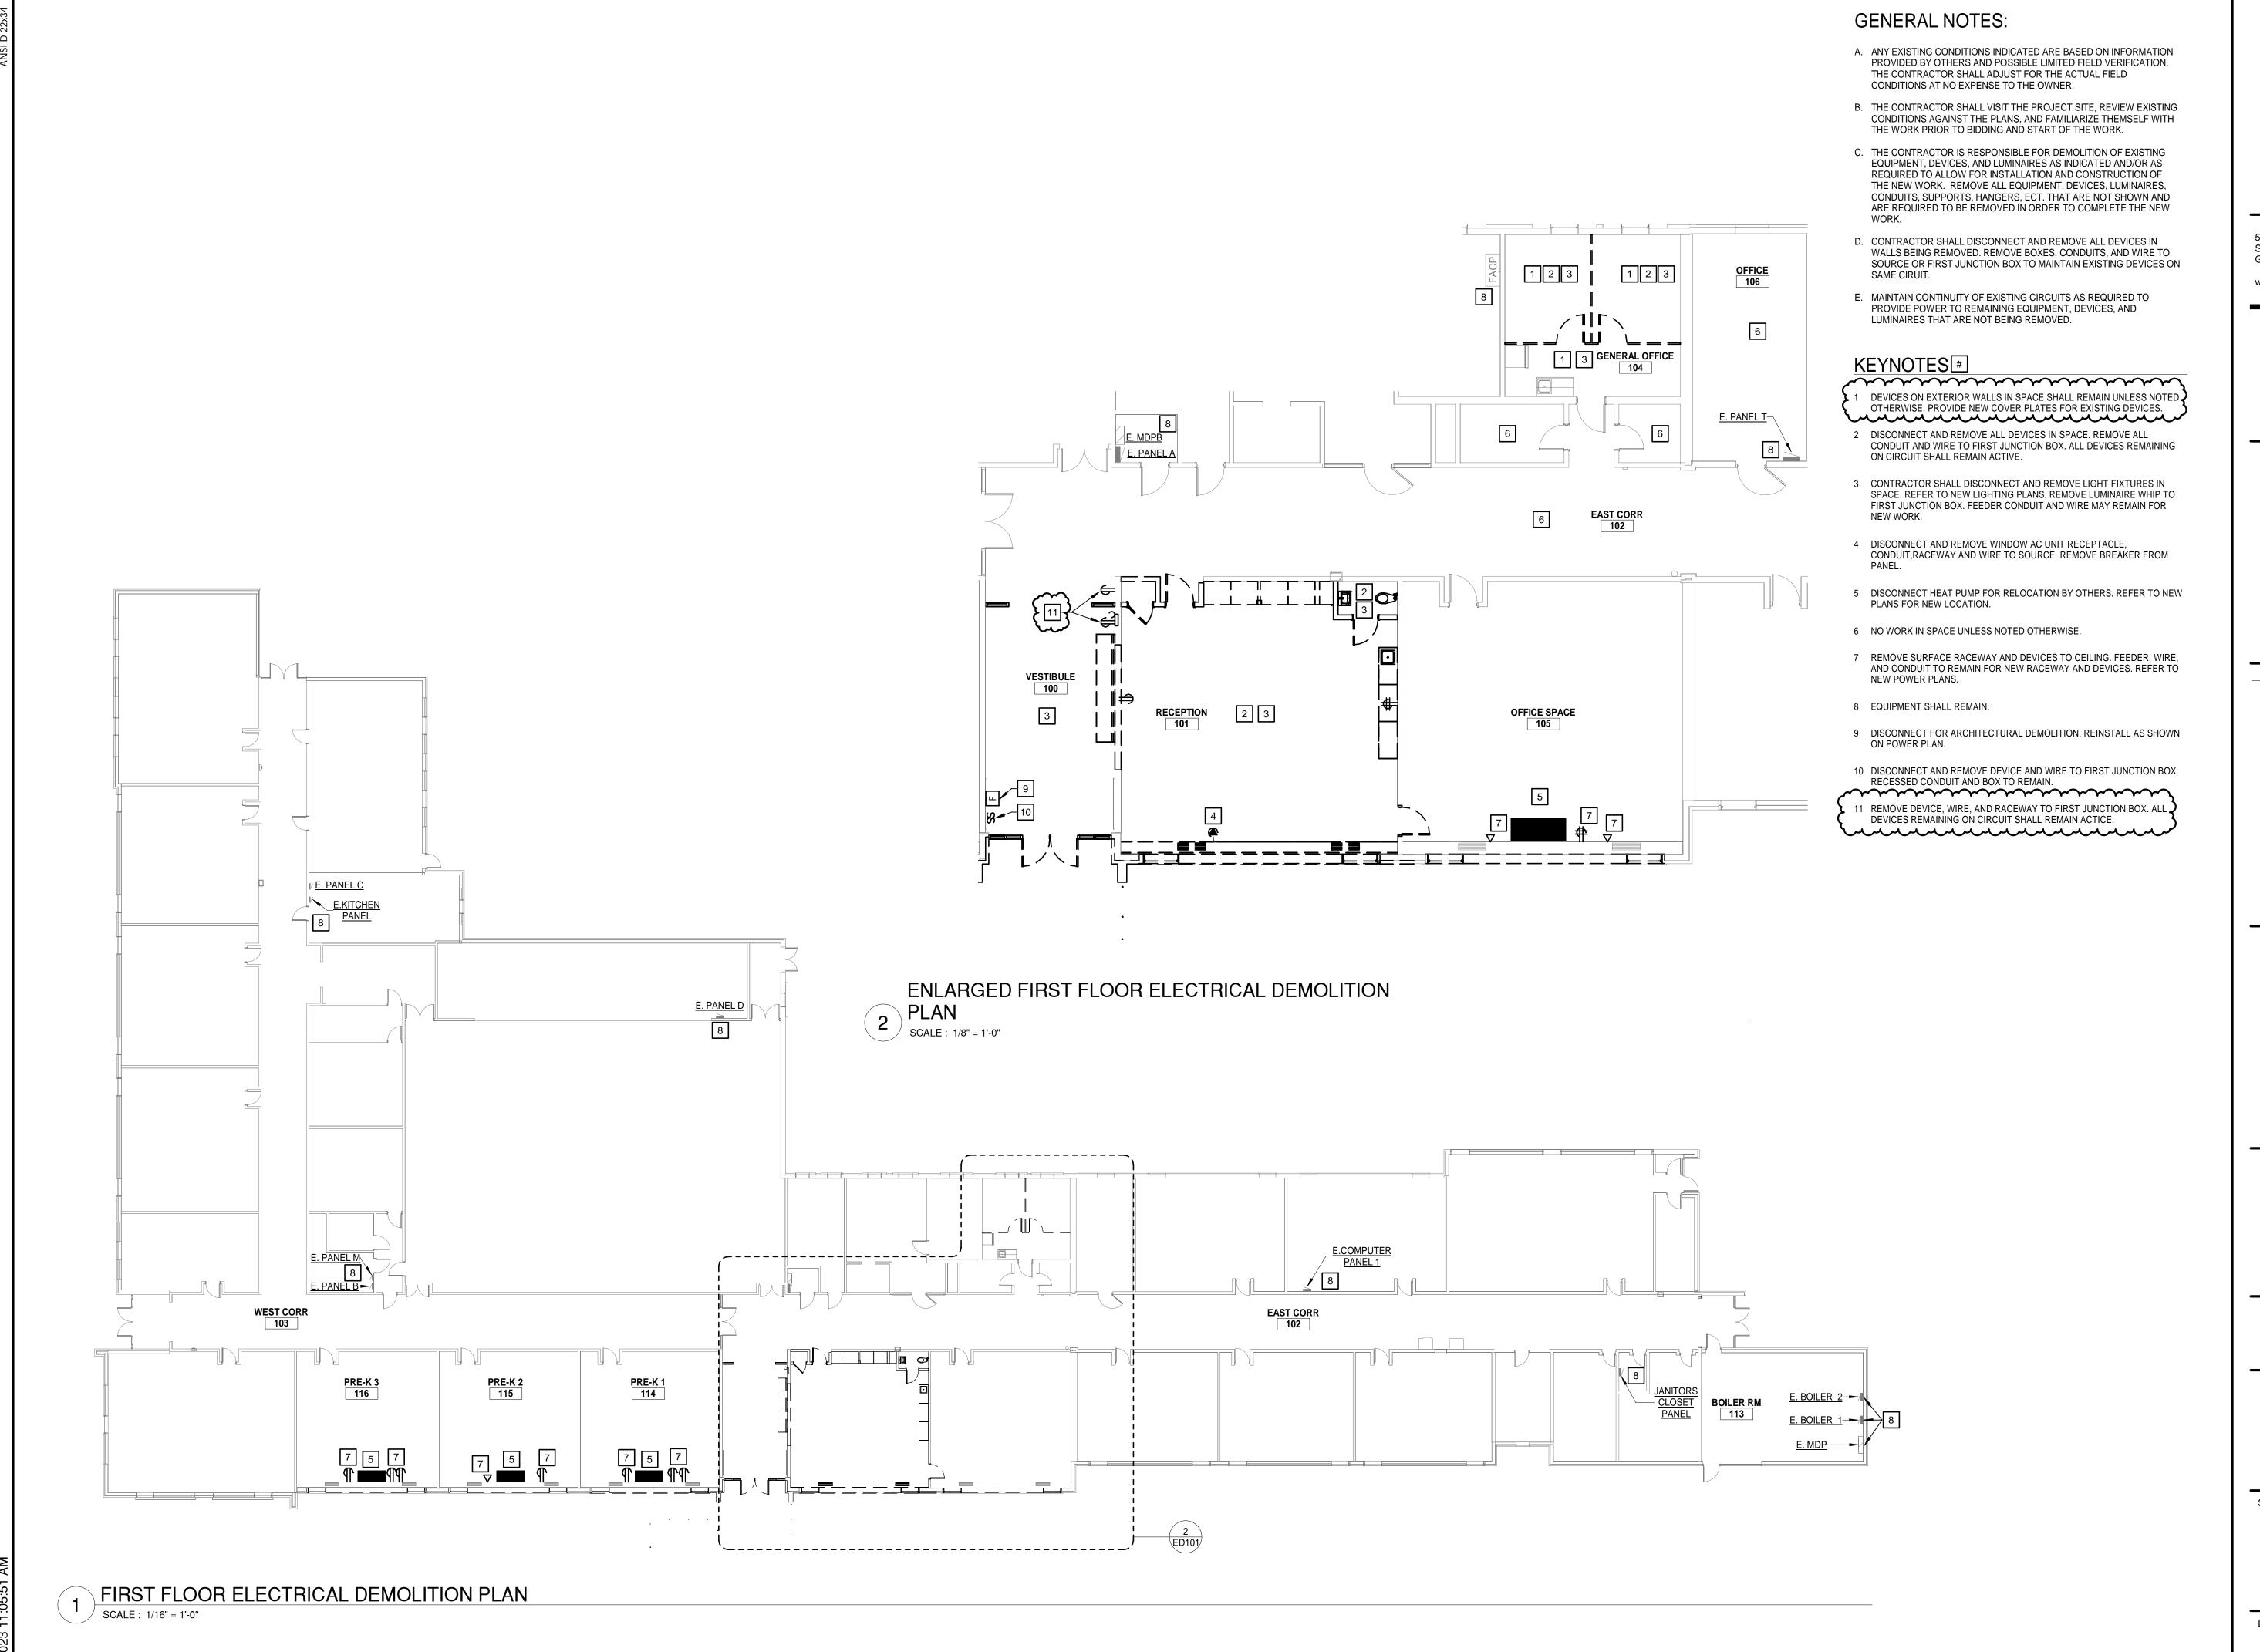



560 5th St. NW Suite 305 Grand Rapids, MI 49504


www.bergmannpc.com

ORCHARD VIEW
SCHOOL
DISTRICT

### COMMUNITY EDUCATION CENTER

1765 ADA AVENUE MUSKEGON, MI 49442

Date Revised	Description
1/24/2023	BID PACKAGE #1 - OWNER REVIEW
1/31/2023 2/7/2023	BID PACKAGE #1 - BIDS BID PACKAGE #1 - PERMITS
2/15/2023 2/17/2023	BID PACKAGE #1 - ADDENDUM #1 BID PACKAGE #1 - ADDENDUM #2

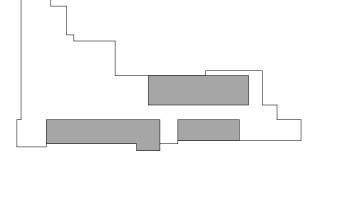

Key Plan

Copyright © Bergmann Associates, Architects, Engineers, Landscape Architects & Surveyors, D.P.C.

Project Manager	Discipline Lead
D HOLTROP	A ROBINSON
Designer	Reviewer
J BOIK	A ROBINSON
Date Issued	Project Number
2/17/2023	16600.00

Sheet Name


ELECTRICAL DEMOLITION PLAN

Drawing Number

ED101

### KEYNOTES (#)

- 1 PROVIDE 30A/3P NON-FUSED NEMA 3R DISCONNECT ON ROOF AND MOUNT ON SEPARATE SUPPORTS. PROVIDE POWER FEED DOWN TO FAN UNIT IN 3/4" CONDUIT. SEAL ALL PENETRATIONS TO MAINTAIN ROOF SYSTEM. PENETRATIONS AND EXPOSED CONDUIT SHALL BE RIGID CONDUIT WITH LFNC FOR FINAL CONNECTION.
- 2 RELOCATED SIDEWALL HEAT PUMP CASSETTE. EXTEND CONDUIT, WIRE, AND CONTROLS AS REQUIRED.
- 3 CIRCUIT NEW RECEPTACLES TO EXISTING CIRCUIT SERVING PREVIOUS RECEPTACLES IN SPACE.
- 4 ALTERNATE 1: DO NOT PROVIDE HCPU-3 AND HPCU-4 SPLIT SYSTEMS. INSTEAD PROVIDE A 240V-1PH, 40A CIRCUIT FROM PANEL RPA. PROVIDE A 40A/2P BREAKER, 2#8,#10EGC IN 3/4-INCH CONDUIT TO ALTERNATE EQUIPMENT.
- 5 ALTERNATE 1: DO NOT PROVIDE HCPU-7 AND HPCU-8 SPLIT SYSTEMS. INSTEAD PROVIDE A 240V-1PH, 40A CIRCUIT FROM PANEL RPA. PROVIDE A 40A/2P BREAKER, 2#8,#10EGC IN 3/4-INCH CONDUIT TO ALTERNATE EQUIPMENT.
- 7 PROVIDE 30A/3P NON-FUSED NEMA 3R DISCONNECT ON ROOF AND MOUNT ON SEPARATE SUPPORTS. PROVIDE 2#10,1#10GEC IN 3/4-INCH CONDUIT. PROVIDE POWER FEED DOWN TO FAN UNIT IN 3/4-INCH CONDUIT. SEAL ALL PENETRATIONS TO MAINTAIN ROOF SYSTEM. PENETRATIONS AND EXPOSED CONDUIT SHALL BE RIGID CONDUIT WITH LFNC FOR FINAL CONNECTION.
- 8 PROVIDE 60A/3P NON-FUSED NEMA 3R DISCONNECT ON ROOF AND MOUNT ON SEPARATE SUPPORTS. PROVIDE 2#8,1#10GEC IN 3/4-INCH CONDUIT. PROVIDE POWER FEED DOWN TO FAN UNIT IN 3/4-INCH CONDUIT. SEAL ALL PENETRATIONS TO MAINTAIN ROOF SYSTEM. PENETRATIONS AND EXPOSED CONDUIT SHALL BE RIGID CONDUIT WITH LFNC FOR FINAL CONNECTION.
- 9 PROVIDE 30A/3P NON-FUSED NEMA 3R DISCONNECT SWITCH
- 10 PROVIDE STEEL WIREMOLD DUAL CHANNEL 4000 SERIES RACEWAY. PROVIDE ALL COMPONENTS NECESSARY FOR A NEAT AND CLEAN INSTALLATION. PROVIDE DEVICES AND CIRCUITS SHOWN. EXTEND EXISTING CIRCUITS FROM REMOVED DEVICES.
- 11 PROVIDE STEEL WIREMOLD DUAL CHANNEL 4000 SERIES RACEWAY. PROVIDE ALL COMPONENTS NECESSARY FOR A NEAT AND CLEAN INSTALLATION. PROVIDE DEVICES AND CIRCUITS SHOWN.
- 12 REINSTALL FIRE ALARM DEVICE

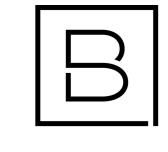

BERGMANN

ARCHITECTS ENGINEERS PLANNERS

560 5th St. NW Grand Rapids, MI 49504


www.bergmannpc.com

### ORCHARD VIEW SCHOOL DISTRICT

### COMMUNITY **EDUCATION** CENTER

1765 ADA AVENUE MUSKEGON, MI 49442

Date Revised	Description
1/24/2023	BID PACKAGE #1 - OWNER REVIEW
1/31/2023	BID PACKAGE #1 - BIDS
2/7/2023	BID PACKAGE #1 - PERMITS
2/15/2023	BID PACKAGE #1 - ADDENDUM #1
2/17/2023	BID PACKAGE #1 - ADDENDUM #2

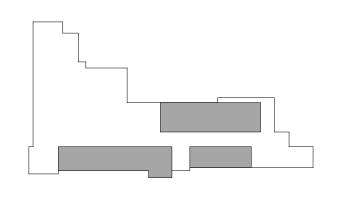

Key Plan


Copyright © Bergmann Associates, Architects, Engineers, Landscape Architects & Surveyors, D.P.C.

Project Manager	Discipling Load
Project Manager	Discipline Lead
D HOLTROP	A ROBINSON
Designer	Reviewer
J BOIK	A ROBINSON
Date Issued	Project Number
2/17/2023	16600.00

Sheet Name

POWER PLAN

**Drawing Number** 

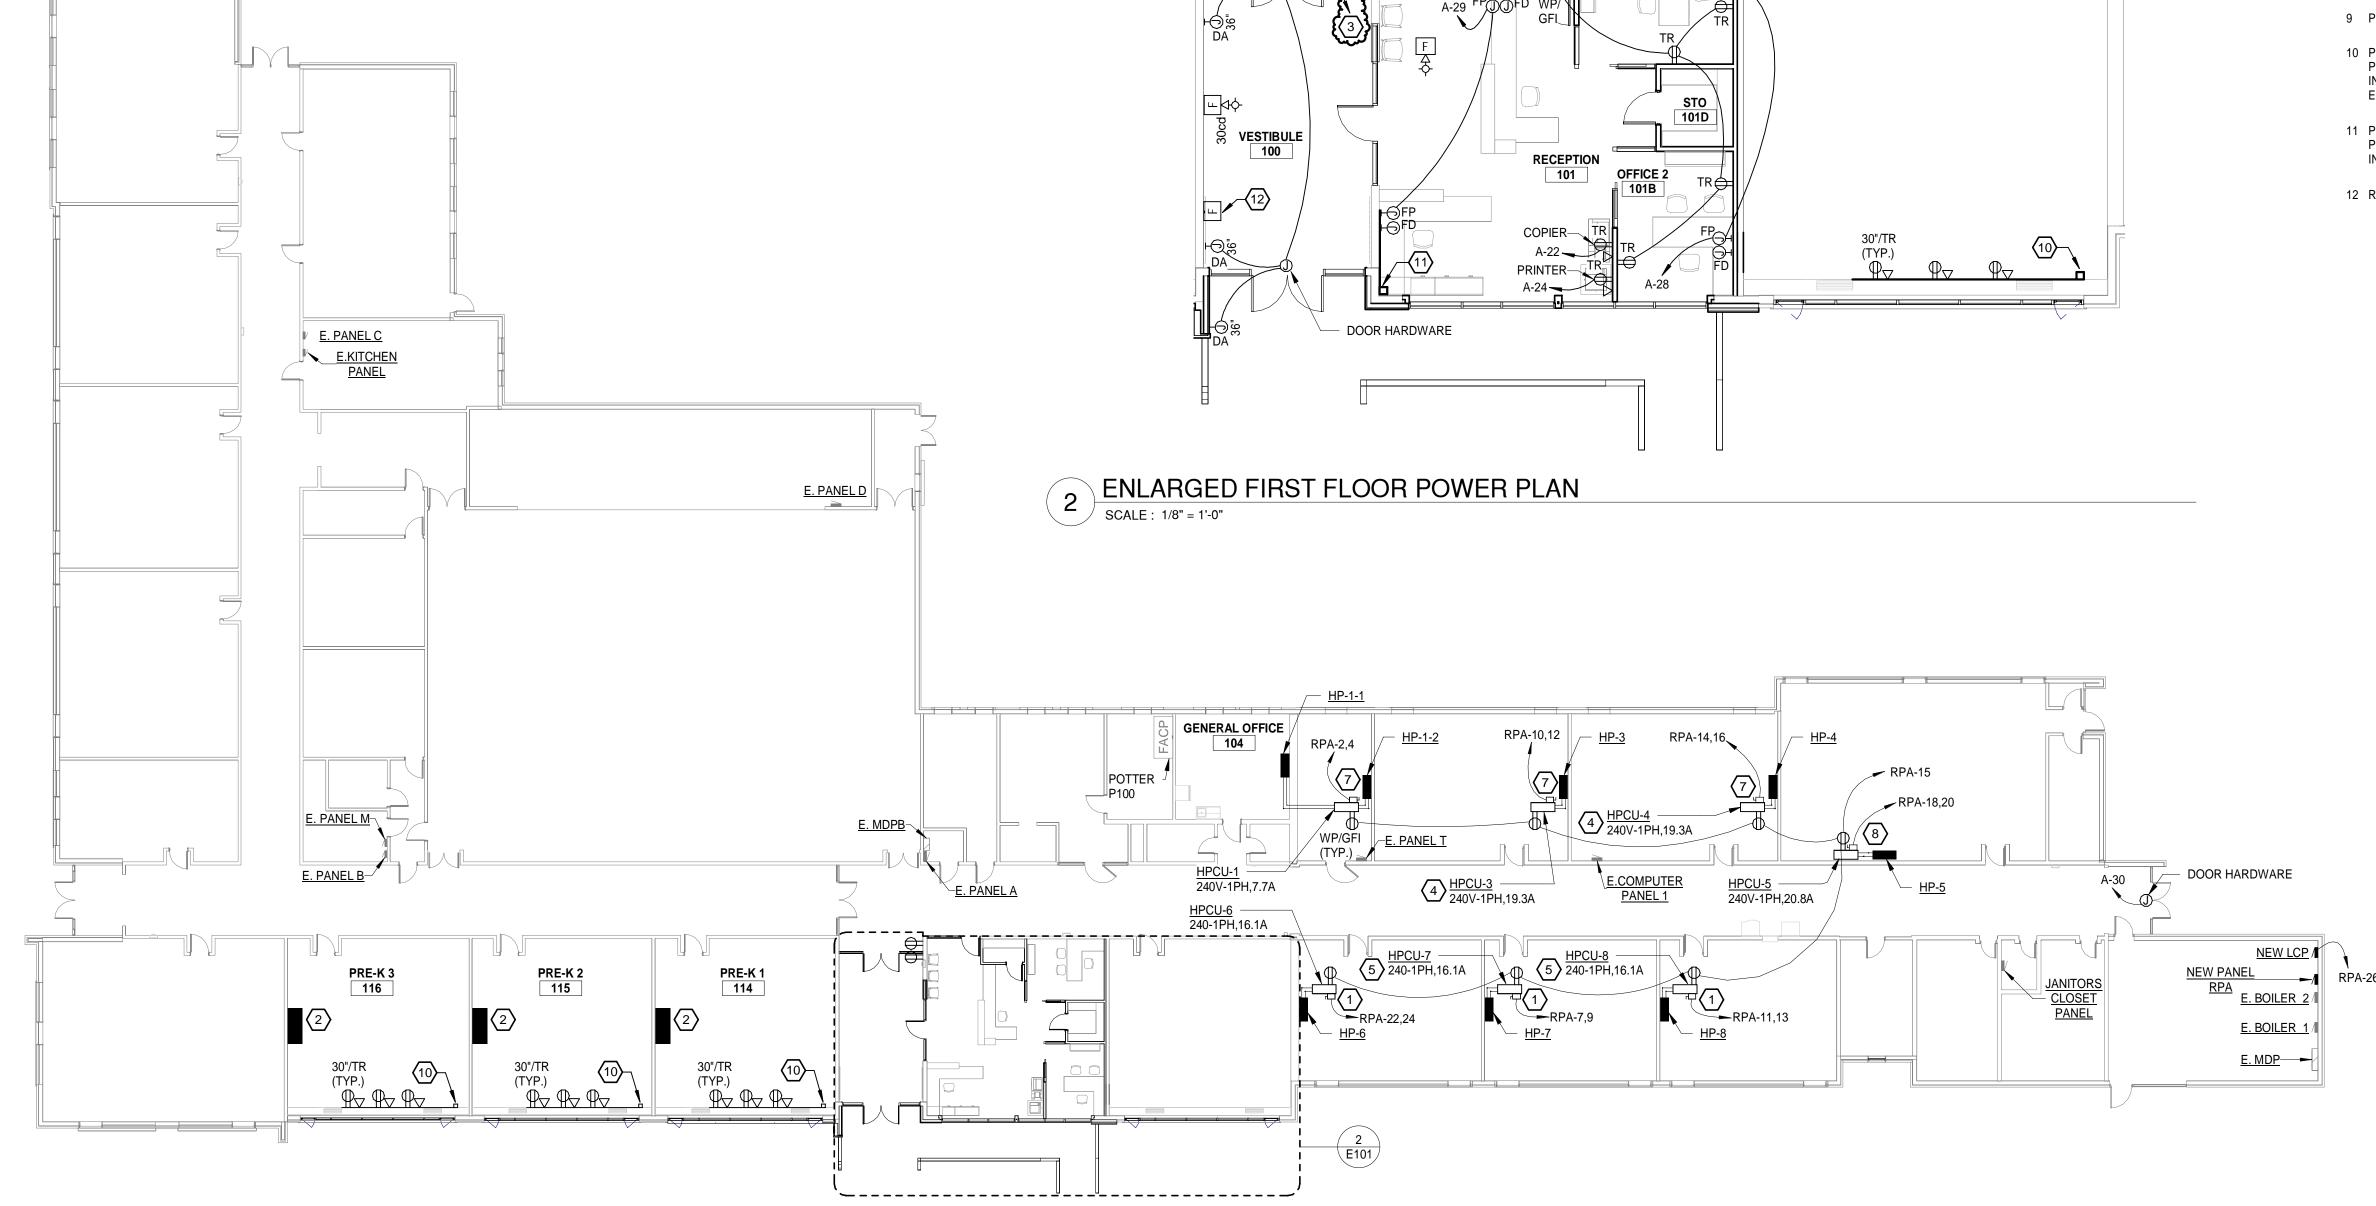

⊮ <u>E. PANEL C</u> 2 ENLARGED FIRST FLOOR LIGHTING PLAN

SCALE: 1/8" = 1'-0" E.KITCHEN PANEL E. PANEL D E. MDPB E.COMPUTER PANEL 1 E. PANEL T NEW PANEL RPA E. BOILER 2 E. BOILER 1/ E. MDP FIRST FLOOR LIGHTING PLAN SCALE: 1/16" = 1'-0"

### KEYNOTES (#)

- 1 REUSE EXISTING LIGHTING CIRCUIT SERVING SPACE.
- 2 PROVIDE LIGHTING CONTROL PANEL WITH 4-RELAYS AND ASTROCLOCK EQUAL TO BLUEBOX LT.
- 3 INSTALL NEW DEVICE AND WIRE. REUSE RECESSED CONDUIT AND BOX.



560 5th St. NW Suite 305 Grand Rapids, MI 49504


www.bergmannpc.com

ORCHARD VIEW SCHOOL DISTRICT

### COMMUNITY **EDUCATION** CENTER

1765 ADA AVENUE MUSKEGON, MI 49442

Date Revised	Description
1/24/2023	BID PACKAGE #1 - OWNER REVIEW
1/31/2023	BID PACKAGE #1 - BIDS
2/7/2023	BID PACKAGE #1 - PERMITS
2/15/2023	BID PACKAGE #1 - ADDENDUM #1
2/17/2023	BID PACKAGE #1 - ADDENDUM #2

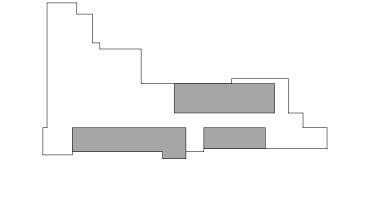

Key Plan

Copyright © Bergmann Associates, Architects, Engineers, Landscape Architects & Surveyors, D.P.C.

Project Manager	Discipline Lead
D HOLTROP	A ROBINSON
Designer	Reviewer
J BOIK	A ROBINSON
Date Issued 2/17/2023	Project Number 16600.00
2/11/2020	10000.00

Sheet Name

LIGHTING PLAN

**Drawing Number** 

SEQUENCE OF OPERATION:

1. LIGHTING CONTROL INTENTION IS TO USE LIGHT FIXTURES WITH INTEGRATED CONTROLS AND ASSOCIATED LOW VOLTAGE SWITCHES, UNLESS NOTED OTHERWISE WITH ROOM CONTROLLERS. DEVIATION FROM THIS SOLUTION SHALL MEET CONTROL INTENTIONS AND COORDINATED WITH ELECTRICAL CONTRACTOR FOR ADDITIONAL WIRING AND INSTALLATION.

2. ALL SWITCHES WITH "LV#" ARE LOW VOLTAGE WIRED CONTROL STATIONS. PROVIDE ON/OFF BUTTONS, PRE-PROGRAMMED SCENES. NETWORK ROOM CONTROLLER AND INTREGRATED CONTROLS TO SYSTEM FOR TIME OF DAY FEATURES

3. LV1: ENCLOSED OFFICE:

A. LIGHTING COME ON AUTOMATICALLY AT 50% UPON ENTRANCE TO SPACE. B. LIGHTING SHALL REMAIN ON UNTIL 20-MINUTES AFTER NO ACTIVITY AND THEN TURN OFF. C. LOCAL OVERRIDE STATIONS SHALL INCLUDE BUTTONS (LABEL: PROGRAMMING):

a. ON: LUMINAIRES 100%. b. 50%: LUMINAIRES AT 50%

d. DIM DOWN e. OFF: LUMINAIRES ALL OFF

4. LV2: OPEN OFFICE:

A. LIGHTING COME ON AUTOMATICALLY AT 50% UPON ENTRANCE TO SPACE.

B. LIGHTING SHALL REMAIN ON UNTIL 20-MINUTES AFTER NO ACTIVITY AND THEN TURN OFF. C. PROVIDE QUANTITY OF ROOM CONTROLLERS AND OCCUPANCY SENSORS PER MANUFACTURER REQUIREMENTS D. LOCAL OVERRIDE STATIONS SHALL INCLUDE BUTTONS (LABEL: PROGRAMMING):

a. ON: LUMINAIRES 100%.

b. 50%: LUMINAIRES AT 50%

d. DIM DOWN e. OFF: LUMINAIRES ALL OFF

6. LV4: CORRIDORS/VESTIBULE:

A. LIGHTING COME ON AUTOMATICALLY AT 50% DURING NORMAL OCCUPIED TIMES. B. OCCUPANCY SENSOR SHALL DIM LIGHTS TO 100% UPON AREA OCCUPANCY

C. OCCUPANCY SENSOR SHALL DIM LIGHTS TO 50% UPON 30 MINUTES OF NO AREA OCCUPANCY

D. NETWORK TO SYSTEM FOR TIME OF DAY. SYSTEM SHALL TURN LIGHTING OFF DURING NON-OCCUPIED TIMES. E. EMERGENCY FIXTURE TO REMAIN ON AS NIGHTLIGHT.

F. PROVIDE QUANTITY OF ROOM CONTROLLERS AND OCCUPANCY SENSORS PER MANUFACTURER REQUIREMENTS G. LOCAL OVERRIDE STATIONS SHALL INCLUDE BUTTONS (LABEL: PROGRAMMING):

a. ON: LUMINAIRES 100%. b. 50%: LUMINAIRES AT 50%

d. DIM DOWN

e. OFF: LUMINAIRES ALL OFF

7. LV5: STORAGE:

A. PROVIDE SWITCH STYLE OCCUPANCY SENSOR.
B. LV7 STATIONS SHALL INCLUDE BUTTONS

A. ON B. OFF

			T	LUMINAIRE SCHEDULE				
YPE	LAMP	MANUFACTURER	MODEL NUMBER	BALLAST/DRIVER	MOUNTING	INPUT WATTAGE	DESCRIPTION	NO
		METALUX	24CZ2-40-UNV-L835-CD1-SWPD1					
	4000 LUMEN,	COLUMBIA	LCAT-24-40-HL-G-ED-U-NXES	0-10V	RECESED GRID CEILING	29W	2x4 TROFFER. PROVIDE INTEGRAL OCCUPANCY SENSOR	
	3500K, LED	LITHONIA	2BLT4-40L-ADSMT-EZ1-LP835-N100-NESPDT7ADCX		CEILING			
		DAYBRITE	2EVO-G-43L-835-4-D-UNV-DIM-SWZG2					
		METALUX	24CZ2-40-UNV-L835-EL7W-CD1-SWPD1					
1	4000 LUMEN,	COLUMBIA	LCAT-24-40-HL-G-ED-U-NXES-ELL14	0-10V	RECESED GRID	29W	2x4 TROFFER. PROVIDE INTEGRAL OCCUPANCY SENSOR AND 7W EMERGENCY BATTERY.	
.	3500K, LED	LITHONIA	2BLT4-40L ADSM- EZ1-LP835-N100-NESPDT7ADCX EL7L		CEILING	2011	ZAT TROTTER. TROTTEE INTEGRALE GOOGLANG FOR EMERGENOT BATTER.	
		DAYBRITE	2EVO-G-43L-835-4-D-UNV-DIM-EMLED-SWZG2					
		METALUX	22CZ2-32HE-UNV-L835-SWPD1-SWPD1-CD1					
	3100 LUMEN,	COLUMBIA	LCAT-22-35-ML-G-ED-U-NXES	0-10V	RECESSED	23.5W	2x2 TROFFER. PROVIDE INTEGRAL OCCUPANCY SENSOR	
	3500K, LED	LITHONIA	2BLT2-33L-ADSMT-EZ1-LP835-N100-NESPDT7ADCX	0-107	CEILING GRID	23.5	2X2 TROFFER. PROVIDE INTEGRAL OCCUPANCY SENSOR	
		DAYBRITE	2EVO-G-45L-835-2-D-UNV-DIM-SWZG2					
		METALUX	22CZ2-32HE-UNV-L835-EL7W-CD1-SWPD1					
	3100 LUMEN,	COLUMBIA	LCAT-22-35-ML-G-ED-U-NXES-ELL14		RECESSED			
1	3500K, LED	LITHONIA	2BLT2-33L-ADSMT-EZ1-LP835-N100-NESPDT7ADCX-EL7L	0-10V	CEILING GRID	23.5W	2x2 TROFFER. PROVIDE INTEGRAL OCCUPANCY SENSOR AND 7W EMERGENCY BATTERY.	
		DAYBRITE	2EVO-G-45L-835-2-D-UNV-DIM-EMLED-SWZG2					
		PRESCOLITE	LTR-6RD-SL-10L-DM1-NXE-LTR-6RD-T-SL-35K-8-MD-SS-WT-B24					
	2000 LUMEN,	GOTHAM	EVO6-35/10-AR-LSS-MD-120-EZ1-NLT-TRW		RECESSED			
	3500K, LED	PORTFOLIO	LD6B-10-D010-EU6B-1020-80-35-6LB-M-0-H-HB26	0-10V	CEILING GRID	22.1W	6" RECESSED CAN.	
		CALCULITE	6R-N-C6L-10-8-35-M-Z10-U-C6-R-DL-CL					
		PRESCOLITE						
	0000 1111451		LTR-6RD-H-ML-DM1-NXE-EMR-LTR-6RD-T-ML-35K-8-MD-SS-WT-B24		DEGEOGED		6" RECESSED CAN. PROVIDE REMOTE TEST SWITCH AND 10W EMERGENCY BATTERY.	
И	2000 LUMEN, 3500K, LED	GOTHAM	EVO6-35/10-AR-LSS-MD-120-EZ1-NLT-TRW-EL	0-10V	RECESSED CEILING GRID	22.1W		
	,	PORTFOLIO	LD6B-20-D010-EU6B-1020-80-35-6LB-M-0-H-HB26					
		CALCULITE	6R-N-EM-C6L-20-8-35-M-Z10-U-C6-R-DL-CL					
		PRESCOLITE	LTR-4RD-H-SL-DM1-NXE-LTR-4RD-T-SL-35K-8-MD-SS-WT-B24				4" RECESSED CAN. PROVIDE INTEGRAL OCCUPANCY SENSOR.	
C2	1100 LUMEN, 3500K, LED	GOTHAM	EVO4-35/10-AR-LSS-MD-120-EZ1-NLT-TRW	0-10V	RECESSED CEILING GRID	12.7W		
		PORTFOLIO	LD4B-10-D010-EU4B-1020-80-35-4LB-M-1-H-HB26	0-10 V				
		CALCULITE	4R-N-C4L-10-8-35-M-Z10-U-C4-R-DL-CL					
		PRESCOLITE	LTR-4SQD-H-SL-DM1-NXE-LTR-4SQD-T-SL-35K-8-MD-SS-WT-B24					
	4400				RECESSED CEILING GRID	12.7W	4" RECESSED SQUARE CAN. PROVIDE INTEGRAL OCCUPANCY SENSOR. PROVIDE PORT TO COMMUNICATE WITH ROOM FIXTURES WITH INTEGRAL SENSORS	
M	1100 LUMEN, 3500K, LED	GOTHAM	EVO4SQ-35-10-AR-LSS-MVOLT-EZ1-NLT-EL	0-10V				
		PORTFOLIO						
	~~~			herry herry	mm	$\lambda \lambda $		~~
		JLC-TECH	TBLX-MW-HO-4-24-DW-A-W-UNV		SUSPENDED 10' AFF	38	4' X 2.25" SUSPENDED LINEAR	
	875 LUMEN/FT, 3500K, LED	OMNILIGHT	GEN2-35-UHO-OCH2458-WH-FR-4ft	0-10V				
	,							
		LITECONTROL	2L-P-ID-STD-4-04-SOF-C1-35					
		JLC-TECH	TBLX-MW-HO-4-24-DW-A-W-UNV-TBEM-XS-12-UNV					
Л	875 LUMEN/FT, 3500K, LED	OMNILIGHT	GEN2-35-UHO-OCH2458-WH-FR-4ft - APO-30-E24	0-10V	SUSPENDED 10' AFF	38	4' X 2.25" SUSPENDED LINEAR. PROVIDE COMPATIBLE EMERGENCY BATTERY.	
	JOJUN, LLD				\ \ \ \ \ \ \ \ \ \ \ \ \ \ \ \ \ \ \			
		LITECONTROL	2L-P-ID-STD-4-04-SOF-C1-35					
		JLC-TECH	TBLX-MW-HO-4-24-DW-U-W-UNV					
	1075 LUMEN/FT,	OMNILIGHT	GEN2-35-UHO-OCH2458-WH-FR-4ft	0-10V	GRID BAR	38	4' X 2.25" T-BAR LINEAR	
	3500K, LED							
		ORACLE	4-LB-LED-2600L-DIM10-MVOLT-35K-85-TB-1516-FT					
		JLC-TECH	TBLX-MW-HO-4-24-DW-U-W-UNV-TBEM-XS-12-UNV					
Л		OMNILIGHT	GEN2-35-UHO-OCH2458-WH-FR-4ft - APO-30-E24	0-10V	GRID BAR	38	4' X 2.25" T-BAR LINEAR. PROVIDE COMPATIBLE EMERGENCY BATTERY.	
'	3500K, LED			U-10V	GUID DAK	30	TA 2.20 TOAN LINEAN. FROVIDE COMPATIBLE EMERGENCT DATTERT.	
		ORACLE	4-LB-LED-2600L-DIM10-MVOLT-35K-85-TB-1516-FT					
		SPI LIGHTING	SEW12145-4FT-28W-120-277V-4000K					
	711 LUMEN/FT,	12	V2355-A-4-1-BBD		EXTERIOR WALL			
	2500K, LED	ELLIPTIPAR	V2335-A-4-1-BBD S-151-R04L-08-M-00-0-840-ZX-HGC	0-10V	MOUNT 17'8"	56W	4-FOOT EXTERIOR WALL BRACKET MOUNTED LIGHT FIXTURE,	
عر	<del>money</del>	ACCLAIM	E-D-D-T	<del>munu</del>	<del>~~~</del>	سسس		<del>し</del>
		EVENLITE						
	LED	LITHONIA	LESG-ELN		UNIVERSAL	1W	DIE CAST ALUMINUM, BLACK HOUSING WITH BRUSHED ALUMINUM FACE, AND GREEN LETTERS.	
	St	SURE-LITES	CX7G					

	NEW PANEL "LCP"									
	IMMER RELAY								T	
DIMME	R/ RELAY	DESCRIPTION	PANELE	BOARD		LOAD		ON/OFF	NOTES	
#	ZONE		NAME	CIR#	LOAD	TYPE	DIMMABLE	SWITCHING	LIGHTING CONTROL STATION	RELAY RATING
1	1	EXTERIOR CAN LIGHTS			67W	LED		X	ASTROCLOCK	30A
2	2	EXTERIOR SIGN LIGHT			56W	LED		X	ASTROCLOCK	30A
3		SPARE								
4		SPARE								

CX7G CCESGE



560 5th St. NW Suite 305 Grand Rapids, MI 49504 www.bergmannpc.com

ORCHARD VIEW SCHOOL DISTRICT

## COMMUNITY **EDUCATION** CENTER

1765 ADA AVENUE MUSKEGON, MI 49442

1		
₹	Date Revised	Description
3		
)	1/24/2023	BID PACKAGE #1 - OWNER REVIEW
7	1/31/2023	BID PACKAGE #1 - BIDS
	2/7/2023	BID PACKAGE #1 - PERMITS
)	2/15/2023	BID PACKAGE #1 - ADDENDUM #1
3	2/17/2023	BID PACKAGE #1 - ADDENDUM #2
₹		
₹		
7		
₹		
)		
3		

Copyright © Bergmann Associates, Architects, Engineers, Landscape Architects & Surveyors, D.P.C.

Project Manager	Discipline Lead
D HOLTROP	A ROBINSON
Designer	Reviewer
J BOIK	A ROBINSON
Date Issued	Project Number
2/17/2023	16600.00

Sheet Name

SCHEDULES

Drawing Number